

Axis Hydraulics BW-24187	INSPECTION & TEST PLAN		ITP NUMBER: 029	Revision No: A	Sanitary Fixtures and Tapware
	Approved for use by Darren Shoobridge, Project Manager		Document No. HYD-ITP-029-L3	Revision Date: 08/09/2026	
	LEVEL 3 — HYDRAULIC SERVICES				

W - Witness; H - Hold Point; S - Surveillance; X - Self Inspection

Drawing Number	HC-201 REV C	Area	Level 3 — Male and Female Amenities — Level 3, Grid 4-6
----------------	--------------	------	---

MATERIALS:			
Item:	Requirements:	Batch / cert. ref.	Check
Sanitary fixtures	Type, model and finish to the fixture schedule, WaterMark certified	WC pans 4 star, WM-024417	X
Tapware and outlets	WELS registered with the specified star rating and flow rate	Basin mixers 5 star, WM-024988	X
Traps and connectors	WaterMark certified traps, flexible connectors to AS 3499 where used	Flexible connectors, WM-024102	X
Sealants and fixings	Sanitary grade silicone and fixings suitable for the substrate	Fixture wastes and traps, WM-024310	X
Accessible fixtures	Grab rails, backrests and fixings to AS 1428.1 with tested fixings	Sealant and fixings, Batch 24-1140	X


INSPECTION & TEST PLAN				
No.	Installation:	Acceptance Criteria	Point	Initial & Date
1.0	Check current revision of drawings issued for construction, including any RFI or site instruction affecting this area.	In accordance with the project Drawing Register. Superseded revisions removed from site.	X	DS 08/09/2026
2.0	Check delivered fixtures and tapware against the fixture schedule — model, finish, handing and WELS rating. Note: Set-out checked against architectural AR-3104 Rev C; accessible pan centreline confirmed at 450mm.	In accordance with the fixture schedule and the specification. No substitutions without written approval.	X	DS 08/09/2026
3.0	Check fixture set out, heights and clearances, including accessible fixtures and circulation space. Fixture height: 800 mm Released by M. Hartley (INSP-3390) 08/09/2026	In accordance with the architectural drawings and AS 1428.1 for accessible sanitary facilities. Deviations approved before installation.	H	DS 08/09/2026
4.0	Check fixing of fixtures, cisterns, pans and accessories to the substrate, including noggins and rated fixings for grab rails.	In accordance with the manufacturer's instructions and AS 1428.1 load requirements for grab rails. Fixings suitable for the substrate.	X	DS 08/09/2026
5.0	Check trap and waste connections, including seal depth and access to the connection.	In accordance with AS/NZS 3500.2:2021 Section 10. No flexible connectors where prohibited.	X	DS 08/09/2026
6.0	Check silicone sealing and junctions to tiling and benches; confirm falls to floor wastes are maintained.	Neat, continuous sanitary grade sealant. No ponding at fixtures or floor wastes.	X	DS 08/09/2026
7.0	Operate every fixture and tap — check flow, isolation, drainage, cistern operation and absence of leaks.	All fixtures operate correctly with no leaks. Flow rates to the WELS rating specified.	X	DS 08/09/2026
8.0	Record hot water delivery temperature at each ablution fixture. Delivery temperature: 44.6 °C Released by M. Hartley (INSP-3390) 08/09/2026	Not exceeding 45 °C at ablution fixtures in early childhood, primary/secondary school, aged care, health care and accommodation buildings; 50 °C elsewhere, in accordance with AS/NZS 3500.4:2021.	H	DS 08/09/2026
9.0	Final clean, protection and defect inspection of fixtures and tapware.	No chips, scratches or staining. Protection reinstated until handover. Defects register updated.	X	DS 08/09/2026
10.0	Record as-installed dimensions, invert levels and deviations for the as-built / work-as-executed drawings.	Marked-up drawings and survey pick-up submitted to the design team prior to covering.	X	DS 08/09/2026

INSTALLER SIGN-OFF Name: Darren Shoobridge Licence / CP no.: Date completed: 08/09/2026 Signature:  Date: 08/09/2026	CLIENT / SUPERINTENDENT ACCEPTANCE Name: M. Hartley Company: BESIX WATPAC 10 of 10 applicable items signed Signature:  Date: 08/09/2026
--	--

PHOTOGRAPHIC RECORD

ITP 029 — Sanitary Fixtures and Tapware · Level 3 — Male and Female Amenities · Level 3, Grid 4-6

Plan extract — HC-201 REV C · Level 3 hydraulic services — layout · 1 highlighted extent, 1 location marked

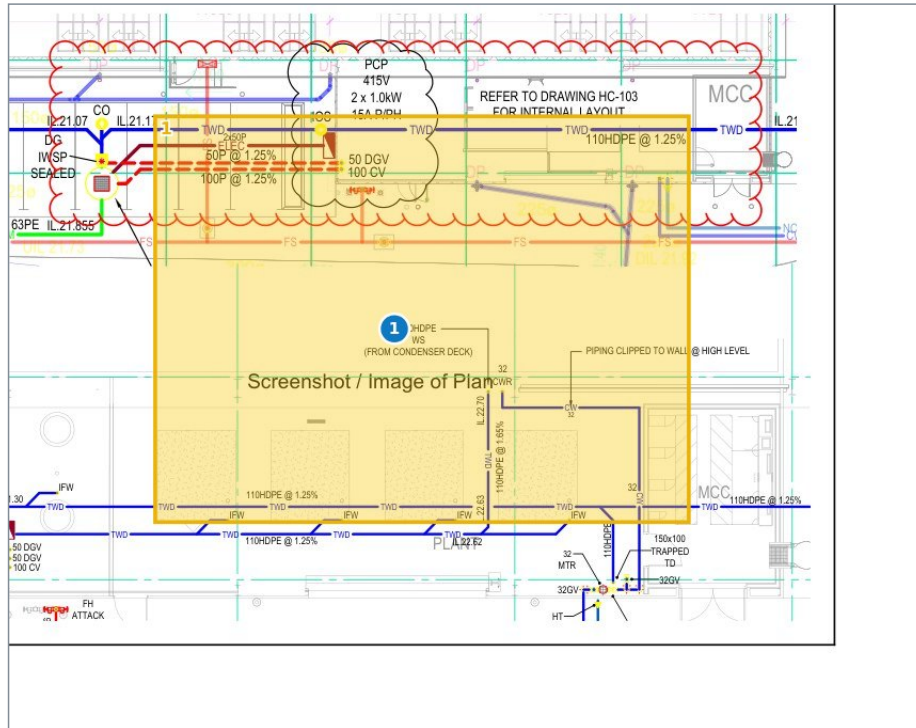

1. Yellow area — Level 3 amenities fixture zone
1. WC pans 1-6 and vanity set out, female amenities (1 photo)

Photographs (3)



Item 1.0 · Installation
08/09/2026 04:46:44 (recorded)



Item 3.0 · Test / gauge
08/09/2026 04:46:56 (recorded)



Pin 1 · Installation
08/09/2026 04:47:18 (recorded)