

|                                   |                                                        |  |                                     |                                     |                   |
|-----------------------------------|--------------------------------------------------------|--|-------------------------------------|-------------------------------------|-------------------|
| Axis Plumbing NSW<br><br>BW-24187 | INSPECTION & TEST PLAN                                 |  | ITP NUMBER:<br><b>016</b>           | Revision No:<br><b>A</b>            | Sanitary Plumbing |
|                                   | Approved for use by Darren Shoobridge, Project Manager |  | ITC #<br><b>000001</b>              | Revision Date:<br><b>24/09/2026</b> |                   |
|                                   | Riverside Precinct — Building A                        |  | Progress 100% · Reviewed & approved |                                     |                   |

H = Hold Point; M = Monitor / Surveillance; W = Witness; X = Self Inspection by performer of work

|                    |                                             |      |                                                   |
|--------------------|---------------------------------------------|------|---------------------------------------------------|
| Drawing Number     | HC-201 REV C                                | Area | Level 3 — Amenities and Riser — Level 3, Grid 4-7 |
| Location / Loc.Ref | CONTROLD0C > HYDRAULICS > SANITARY PLUMBING |      |                                                   |

| MATERIALS:                      |                                                                         |                                      |       |
|---------------------------------|-------------------------------------------------------------------------|--------------------------------------|-------|
| Item:                           | Requirements:                                                           | Batch / cert. ref.                   | Check |
| Sanitary pipework               | PVC-U DWV to AS/NZS 1260, WaterMark certified                           | DWV PVC-U 100/65/50, WM-020458       | X     |
| Fittings and solvent cement     | AS/NZS 1260 fittings, priming fluid and cement to AS/NZS 3879           | Solvent cement type P, Batch 24-0917 | X     |
| HDPE pipework (where specified) | PE to AS/NZS 5065 with electrofusion / butt fusion joints               | Inspection openings, WM-020458       | X     |
| Brackets and supports           | Proprietary supports at the centres required by AS/NZS 3500.2 Section 8 | Brackets and clips, Batch 24-0955    | X     |
| Fire collars                    | Tested system to AS 4072.1 matching the FRL of the element penetrated   | Vent cowls, WM-021234                | X     |

| INSPECTION & TEST PLAN |                                                                                                                                                                                                                                      |                                                                                                                                                                                       |       |                  |
|------------------------|--------------------------------------------------------------------------------------------------------------------------------------------------------------------------------------------------------------------------------------|---------------------------------------------------------------------------------------------------------------------------------------------------------------------------------------|-------|------------------|
| No.                    | Installation:                                                                                                                                                                                                                        | Acceptance Criteria                                                                                                                                                                   | Point | Initial & Date   |
| 1.0                    | Check current revision of drawings issued for construction, including any RFI or site instruction affecting this area.                                                                                                               | In accordance with the project Drawing Register. Superseded revisions removed from site.                                                                                              | X     | DS<br>24/09/2026 |
| 2.0                    | Set out sanitary plumbing against the coordinated services model / shop drawings. Confirm no clash with structure, ductwork, electrical or ceiling zones and that the design falls or grades can be achieved.                        | In accordance with the coordinated shop drawings and the hydraulic specification. Clashes resolved and reissued before installation.                                                  | X     | DS<br>24/09/2026 |
| 3.0                    | Check materials delivered to site for compliance and damage (PVC-U DWV / HDPE — check for damage and correct SN/class). Record batch / lot numbers and WaterMark or certification details.                                           | In accordance with AS/NZS 3500.2:2021 Section 2.3 'Selection and Use of Materials and Products', WaterMark certification and the hydraulic specification.                             | X     | DS<br>24/09/2026 |
| 4.0                    | Check pipe support, bracketing and fixing centres, including provision for thermal movement and seismic restraint where specified.                                                                                                   | In accordance with AS/NZS 3500.2:2021 Section 8 'Fixing and Support', manufacturer's requirements and the hydraulic specification. Fixings suitable for the substrate.                | X     | DS<br>24/09/2026 |
| 5.0                    | Check pipe sizes, grades and fall of all branch and stack pipework against the approved drawings.<br>Grade achieved: 1.65 %                                                                                                          | In accordance with AS/NZS 3500.2:2021 Section 6 'Sanitary Plumbing' and Section 3.4 for grades. Minimum falls achieved throughout.                                                    | X     | DS<br>24/09/2026 |
| 6.0                    | Check trap types, seal depths and trap ventilation for each fixture group.<br>Trap seal depth: 50 mm                                                                                                                                 | Trap seal depth and venting in accordance with AS/NZS 3500.2:2021 Section 6 'Venting' and Section 10. No unvented arrangement outside the permitted limits.                           | X     | DS<br>24/09/2026 |
| 7.0                    | Check stack offsets, expansion joints, and provision for building and thermal movement.                                                                                                                                              | In accordance with AS/NZS 3500.2:2021 and the pipe manufacturer's requirements. Anchors and guides installed as detailed.                                                             | X     | DS<br>24/09/2026 |
| 8.0                    | Check inspection openings and access points to stacks and branches are provided and accessible after fit-out.                                                                                                                        | In accordance with AS/NZS 3500.2:2021 and the approved drawings. Access panels coordinated with the architect.                                                                        | X     | DS<br>24/09/2026 |
| 9.0                    | Check penetrations through fire and acoustic rated elements are sealed with a tested and approved system.<br>Note: Fire collars installed by others to the tested system; penetrations witnessed and photographed before closing in. | Fire collars / wraps installed in accordance with AS 4072.1 and the tested system, matching the FRL of the element penetrated. Acoustic seals in accordance with the acoustic report. | M     | DS<br>24/09/2026 |
| 10.0                   | Check acoustic lagging to stacks and branches within noise-sensitive areas.                                                                                                                                                          | In accordance with the acoustic report and the hydraulic specification. Lagging continuous, including at brackets and penetrations.                                                   | X     | DS<br>24/09/2026 |
| 11.0                   | Hydrostatic test with water to finished ground level, minimum test duration of 15 minutes.<br>Test duration held: 30 minutes<br>Released by M. Hartley (INSP-3341) 24/09/2026                                                        | 15 minutes or greater with no loss of water, in accordance with AS/NZS 3500.2:2021 Section 15 'Testing'.                                                                              | W     | DS<br>24/09/2026 |
| 12.0                   | Air test the installed section, pressurised and stabilised prior to timing the test.<br>Test pressure held: 1500 kPa<br>Released by M. Hartley (INSP-3341) 24/09/2026                                                                | Test pressure of 30 kPa held for a minimum of 15 minutes with no measurable loss, in accordance with AS/NZS 3500.2:2021 Section 15 'Testing' and the hydraulic specification.         | W     | DS<br>24/09/2026 |
| 13.0                   | Apply pipe identification and directional flow markings to the sanitary plumbing.                                                                                                                                                    | Black / "SANITARY" identification in accordance with AS 1345 and AS 2700, at intervals and locations required by the hydraulic specification.                                         | X     | DS<br>24/09/2026 |
| 14.0                   | Seal test gates and cap all open ends on completion of the section.                                                                                                                                                                  | Dust caps and temporary seals fitted to all open ends to prevent ingress of debris.                                                                                                   | X     | DS<br>24/09/2026 |
| 15.0                   | Flush pipework on completion of that section and confirm free discharge.                                                                                                                                                             | In accordance with the hydraulic specification. No debris, free flow                                                                                                                  | X     | DS               |

| INSPECTION & TEST PLAN |                                                                                                                 |                                                                                           |       |                  |
|------------------------|-----------------------------------------------------------------------------------------------------------------|-------------------------------------------------------------------------------------------|-------|------------------|
| No.                    | Installation:                                                                                                   | Acceptance Criteria                                                                       | Point | Initial & Date   |
|                        |                                                                                                                 | observed at the downstream point.                                                         |       | 24/09/2026       |
| 16.0                   | Final visual inspection of the completed installation; make good all damage, protective coatings and surrounds. | No visible defects. Area left clean and all protection removed. Defects register updated. | X     | DS<br>24/09/2026 |
| 17.0                   | Record as-installed dimensions, invert levels and deviations for the as-built / work-as-executed drawings.      | Marked-up drawings and survey pick-up submitted to the design team prior to covering.     | X     | DS<br>24/09/2026 |


| TEST RECORD (3.0)                                |                                                       |
|--------------------------------------------------|-------------------------------------------------------|
| Step 1 Australian Standard minimum test criteria | AS/NZS 3500.2:2018 section 15.2 · 30 kPa · 15 minutes |
| Step 2 Service                                   | Sanitary Plumbing                                     |
| Step 3 Test type                                 | AIR TEST                                              |
| Step 4 Date of test                              |                                                       |
| Step 5 Final test — time started / ended         |                                                       |
| Step 6 Pressure at start (kPa)                   |                                                       |
| Step 7 Pressure loss (kPa) or loss at end (ml)   |                                                       |
| Step 8 Test equipment                            |                                                       |
| Step 9 Total loss (kPa) or make-up water (ml)    |                                                       |
| Step 10 Test pass                                |                                                       |
| Step 11 ITP compliance check complete            |                                                       |
| Step 12 Additional notes                         |                                                       |

| AXIS SIGN-OFF                                                                                                                                                                                     | ADDITIONAL SIGN-OFF (CLIENT / SUPERINTENDENT)                                                                                                                                                         |
|---------------------------------------------------------------------------------------------------------------------------------------------------------------------------------------------------|-------------------------------------------------------------------------------------------------------------------------------------------------------------------------------------------------------|
| Name: Darren Shoobridge<br>Licence / CP no.:<br>Date completed: 24/09/2026<br><br>Signature:  Date: 24/09/2026 | Name: M. Hartley<br>Company: BESIX WATPAC<br>17 of 17 applicable items signed<br><br>Signature:  Date: 24/09/2026 |

PHOTOGRAPHIC RECORD

ITP 016 — Sanitary Plumbing · Level 3 — Amenities and Riser · Level 3, Grid 4-7

Plan extract — HC-201 REV C · Level 3 hydraulic services — layout · 1 highlighted extent, 1 location marked

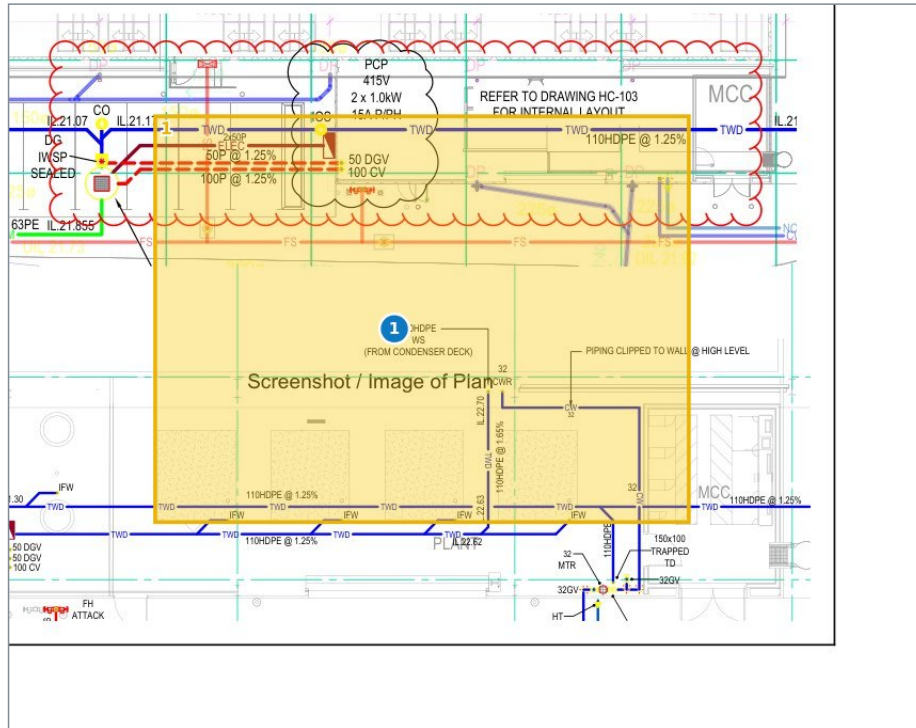

1. Yellow area — Level 3 amenities — sanitary plumbing extent
1. Stack SS-01 at grid 5, connection to Level 2 below (1 photo)

Photographs (3)



24/09/2026 05:55:39  
ITP 016 — Sanitary Plumbing  
Level 3 — Amenities and Riser · Item 1.0

Item 1.0 · Installation  
24/09/2026 05:55:39 (recorded)



24/09/2026 05:55:50  
ITP 016 — Sanitary Plumbing  
Level 3 — Amenities and Riser · Item 3.0

Item 3.0 · Installation  
24/09/2026 05:55:50 (recorded)



24/09/2026 05:56:19  
ITP 016 — Sanitary Plumbing  
Level 3 — Amenities and Riser · Pin 1

Pin 1 · Installation  
24/09/2026 05:56:19 (recorded)

