

Axis Plumbing NSW BW-24187	INSPECTION & TEST PLAN	ITP NUMBER: 023	Revision No: A	Potable Cold Water
	Approved for use by Darren Shoobridge, Project Manager	ITC # 000002	Revision Date: 24/09/2026	
	Riverside Precinct — Building A	Progress 100% · Reviewed & approved		

H = Hold Point; M = Monitor / Surveillance; W = Witness; X = Self Inspection by performer of work

Drawing Number	HC-201 REV C	Area	Level 3 — Cold Water Reticulation — Level 3, Grid 1-7
Location / Loc.Ref	CONTROLD0C > HYDRAULICS > POTABLE COLD WATER		

MATERIALS:			
Item:	Requirements:	Batch / cert. ref.	Check
Cold water pipework	Copper Type B to AS 1432, or PEX / PP-R / stainless as specified, WaterMark certified	Press copper Type B 40mm, WM-020017	X
Fittings	Press / capillary / crimp fittings to AS 3688 or the system manufacturer, WaterMark certified	Press fittings, WM-020017	X
Drinking water suitability	All wetted products certified to AS/NZS 4020	PEX-b 25/20/16, WM-023119	X
Valves	Isolation and non-return valves to the specified class, with union connections	DZR isolation valves, WM-022118	X
Insulation	Thickness and vapour barrier to NCC Section J and the specification	Insulation 25mm, Batch 24-1102	X


INSPECTION & TEST PLAN				
No.	Installation:	Acceptance Criteria	Point	Initial & Date
1.0	Check current revision of drawings issued for construction, including any RFI or site instruction affecting this area.	In accordance with the project Drawing Register. Superseded revisions removed from site.	X	DS 24/09/2026
2.0	Set out potable cold water against the coordinated services model / shop drawings. Confirm no clash with structure, ductwork, electrical or ceiling zones and that the design falls or grades can be achieved.	In accordance with the coordinated shop drawings and the hydraulic specification. Clashes resolved and reissued before installation.	X	DS 24/09/2026
3.0	Check materials delivered to site for compliance and damage (Copper Type B / PEX / PP-R / stainless — WaterMark and AS/NZS 4020 certified). Record batch / lot numbers and WaterMark or certification details.	In accordance with AS/NZS 3500.2:2021 Section 2.3 'Selection and Use of Materials and Products', WaterMark certification and the hydraulic specification.	X	DS 24/09/2026
4.0	Check pipe support, bracketing and fixing centres, including provision for thermal movement and seismic restraint where specified.	In accordance with AS/NZS 3500.1:2021 Section 5 'Water Service Installation', manufacturer's requirements and the hydraulic specification. Fixings suitable for the substrate.	X	DS 24/09/2026
5.0	Check pipe sizes against the approved hydraulic drawings and the sizing calculation, including riser and branch sizes.	In accordance with AS/NZS 3500.1:2021 Section 3 'Design' and the approved drawings.	X	DS 24/09/2026
6.0	Check jointing method, tool calibration and jaw condition for pressed / crimped systems.	In accordance with the system manufacturer's instructions. Tool service records current, correct jaws used for each size.	M	DS 24/09/2026
7.0	Check isolation valve locations, meters, strainers and non-return valves; confirm access for maintenance.	In accordance with the approved drawings. Valves accessible, labelled and shown on the valve chart.	X	DS 24/09/2026
8.0	Install and commission backflow prevention device appropriate to the assessed hazard rating. Register the device with the water authority. Released by M. Hartley (INSP-3352) 24/09/2026	In accordance with AS/NZS 3500.1:2021 Section 4 'Cross-connection Control', AS 2845.1 and the water authority requirements. Commissioning report by an accredited backflow tester.	H	DS 24/09/2026
9.0	Check dissimilar metal separation and provision for thermal movement in long runs and risers.	In accordance with AS/NZS 3500.1:2021 and the manufacturer's requirements. Dielectric separation where required.	X	DS 24/09/2026
10.0	Check penetrations through fire and acoustic rated elements are sealed with a tested and approved system.	Fire collars / wraps installed in accordance with AS 4072.1 and the tested system, matching the FRL of the element penetrated. Acoustic seals in accordance with the acoustic report.	M	DS 24/09/2026
11.0	Check pipe insulation type, thickness and vapour sealing, including at supports and valves.	In accordance with NCC Section J and the hydraulic specification. Continuous, unbroken vapour barrier with no compression at supports.	X	DS 24/09/2026
12.0	Hydrostatic pressure test of the completed section to 1500 kPa (or 1.5 × maximum working pressure, whichever is the greater) held for 30 minutes. Test pressure held: 1500 kPa Note: Held with no measurable drop for the full period. Gauge calibration certificate on file with the test record. Released by M. Hartley (INSP-3352) 24/09/2026	No loss of pressure and no visible leakage over 30 minutes, in accordance with AS/NZS 3500.1:2021 Section 16 'Testing and Commissioning' and the hydraulic specification.	W	DS 24/09/2026
13.0	Flush pipework on completion of that section and confirm free discharge.	In accordance with the hydraulic specification. No debris, free flow observed at the downstream point.	X	DS 24/09/2026
14.0	Disinfect the potable water installation and flush. Sample and test for bacteriological compliance before the system is put into service. Released by M. Hartley (INSP-3352) 24/09/2026	In accordance with AS/NZS 3500.1:2021 Section 16 'Testing and Commissioning' and the water authority requirements. NATA laboratory results to confirm compliance with the Australian Drinking Water Guidelines.	H	DS 24/09/2026

INSPECTION & TEST PLAN				
No.	Installation:	Acceptance Criteria	Point	Initial & Date
15.0	Apply pipe identification and directional flow markings to the potable cold water.	Blue / "POTABLE WATER" to AS 1345 and AS 2700 identification in accordance with AS 1345 and AS 2700, at intervals and locations required by the hydraulic specification.	X	DS 24/09/2026
16.0	Operate and label all isolation valves; confirm access, orientation and zone of control.	Valves accessible and operable, labelled to the valve schedule, and shown on the valve chart.	X	DS 24/09/2026
17.0	Final visual inspection of the completed installation; make good all damage, protective coatings and surrounds.	No visible defects. Area left clean and all protection removed. Defects register updated.	X	DS 24/09/2026
18.0	Record as-installed dimensions, invert levels and deviations for the as-built / work-as-executed drawings.	Marked-up drawings and survey pick-up submitted to the design team prior to covering.	X	DS 24/09/2026

TEST RECORD (3.0)	
Step 1 Australian Standard minimum test criteria	AS/NZS 3500 · 1500 kPa · 30 minutes
Step 2 Service	Potable Cold Water
Step 3 Test type	PRESSURE TEST
Step 4 Date of test	
Step 5 Final test — time started / ended	
Step 6 Pressure at start (kPa)	
Step 7 Pressure loss (kPa) or loss at end (ml)	
Step 8 Test equipment	
Step 9 Total loss (kPa) or make-up water (ml)	
Step 10 Test pass	
Step 11 ITP compliance check complete	
Step 12 Additional notes	

AXIS SIGN-OFF Name: Darren Shoobridge Licence / CP no.: Date completed: 24/09/2026 Signature:  Date: 24/09/2026	ADDITIONAL SIGN-OFF (CLIENT / SUPERINTENDENT) Name: M. Hartley Company: BESIX WATPAC 18 of 18 applicable items signed Signature:  Date: 24/09/2026
---	---

Plan extract — HC-201 REV C · Level 3 hydraulic services — layout · 1 highlighted extent, 1 location marked

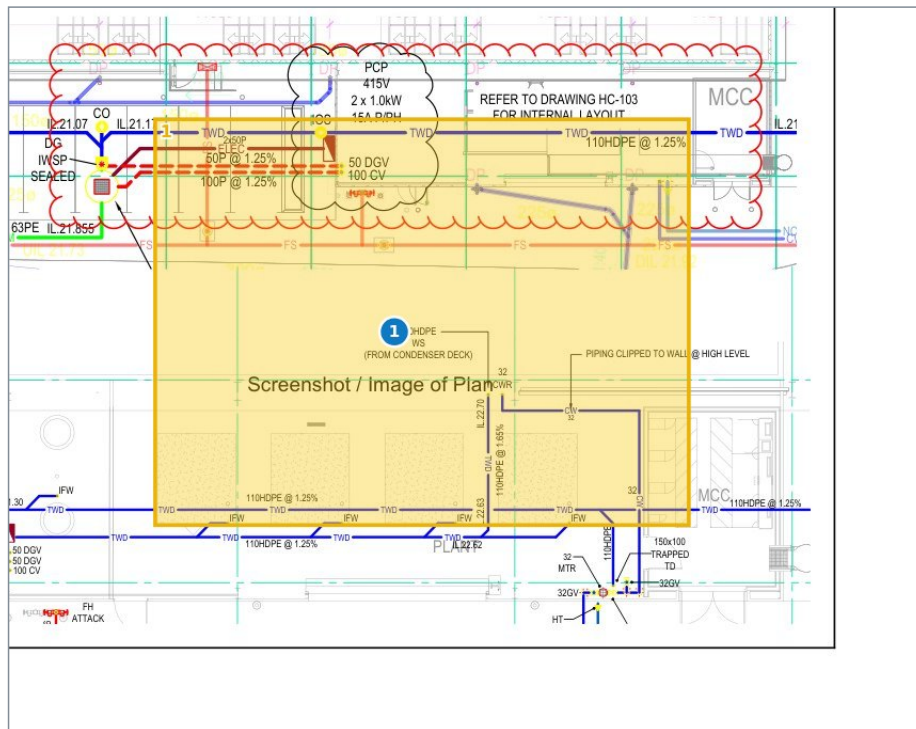

1. Yellow area — Cold water reticulation, grid 1-7
1. CW riser take-off, isolation valve CW-V03 (1 photo)

re

24/09/2026 05:56:39
ITP 023 - Potable Cold Water
Level 3 - Cold Water Reticulation - Item 1.0

re

24/09/2026 05:56:49
ITP 023 - Potable Cold Water
Level 3 - Cold Water Reticulation - Item 3.0

re

24/09/2026 05:57:22
ITP 023 - Potable Cold Water
Level 3 - Cold Water Reticulation - Pin 1

Item 1.0 - Installation
24/09/2026 05:56:39 (recorded)

Item 3.0 - Installation
24/09/2026 05:56:49 (recorded)

Pin 1 - Installation
24/09/2026 05:57:22 (recorded)